

STATE OF UTAH  
DEPARTMENT OF NATURAL RESOURCES  
DIVISION OF OIL, GAS AND MINING  
1594 West North Temple - Suite 1210  
Box 145801  
Salt Lake City, Utah 84114-5801  
Telephone: (801) 538-5291  
Fax: (801) 359-3940

LARGE MINING OPERATIONS 2008 PROGRESS REPORT  
January 1, 2008 to December 31, 2008

The information required in this form are based on provisions of the Mined Land Reclamation Act, Title 40-8, and the rules as under the Utah Minerals Regulatory Program.

1. Mine Permit Number: M/023/016
2. Mine Name: Levan - Chicken Creek
3. Name of Operator/Permittee: Sunroc Corporation  
Note: If Operator's address, company representative or phone number have changed, please provide a replacement page for the Notice of Intention.
4. Mine Location: . 7 miles east of Levan in Chicken Creek Canyon
5. Report the gross amount of ore mined and waste moved, and the disposition of the materials (onsite stockpiles, sold, waste pile, regraded, etc.):  

|                      |   |
|----------------------|---|
| Gross Ore Mined      | <u>108,366</u> Tons, or _____ yd <sup>3</sup> |
| Waste Material Moved | <u>0</u> Tons, or _____ yd <sup>3</sup>       |
| New Disturbance      | <u>0</u> Acres during 2008                    |
| Area Reclaimed       | <u>0</u> Acres during 2008                    |
| Total Disturbed Area | <u>4865</u> Acres*                            |

\*Total mine disturbance from the beginning of mining operations through the end of 2008.

Was the ore shipped off site? If not, where is the ore located? yes

Where is the waste located? In the fines stockpile on the east end of the processing pad
6. Briefly describe the reclamation work performed during the past year. A map showing reclaimed areas and dates is suggested. (Submit form MR-SITE for an application for full or partial bond/site release).  
none
7. Include an updated map depicting surface disturbance and reclamation performed during the year, prepared in accordance with Rule R647-4-105.

I hereby certify, under penalties of law, the information provided in this report is true and correct to the best of my knowledge and belief.

Name (Typed or Print): Tony L Christofferson  
Title of Operator: Property / Environmental manager  
Signature of Operator: Tony L Christofferson  
Date: 1-22-09



RECEIVED

JAN 26 2009

DIV. OF OIL, GAS & MINING



Scale: 1" = 500'

**DISTURBED AREA MAP**  
of the  
**LEVAN CHICKEN CREEK**  
**(WEST MINE) M/023/016**

**HE DAVIS CONSTRUCTION**  
Spanish Fork, Utah


contour interval 50'

— Disturbed Area


Date: 10/4/05

Drawing #

III - A W

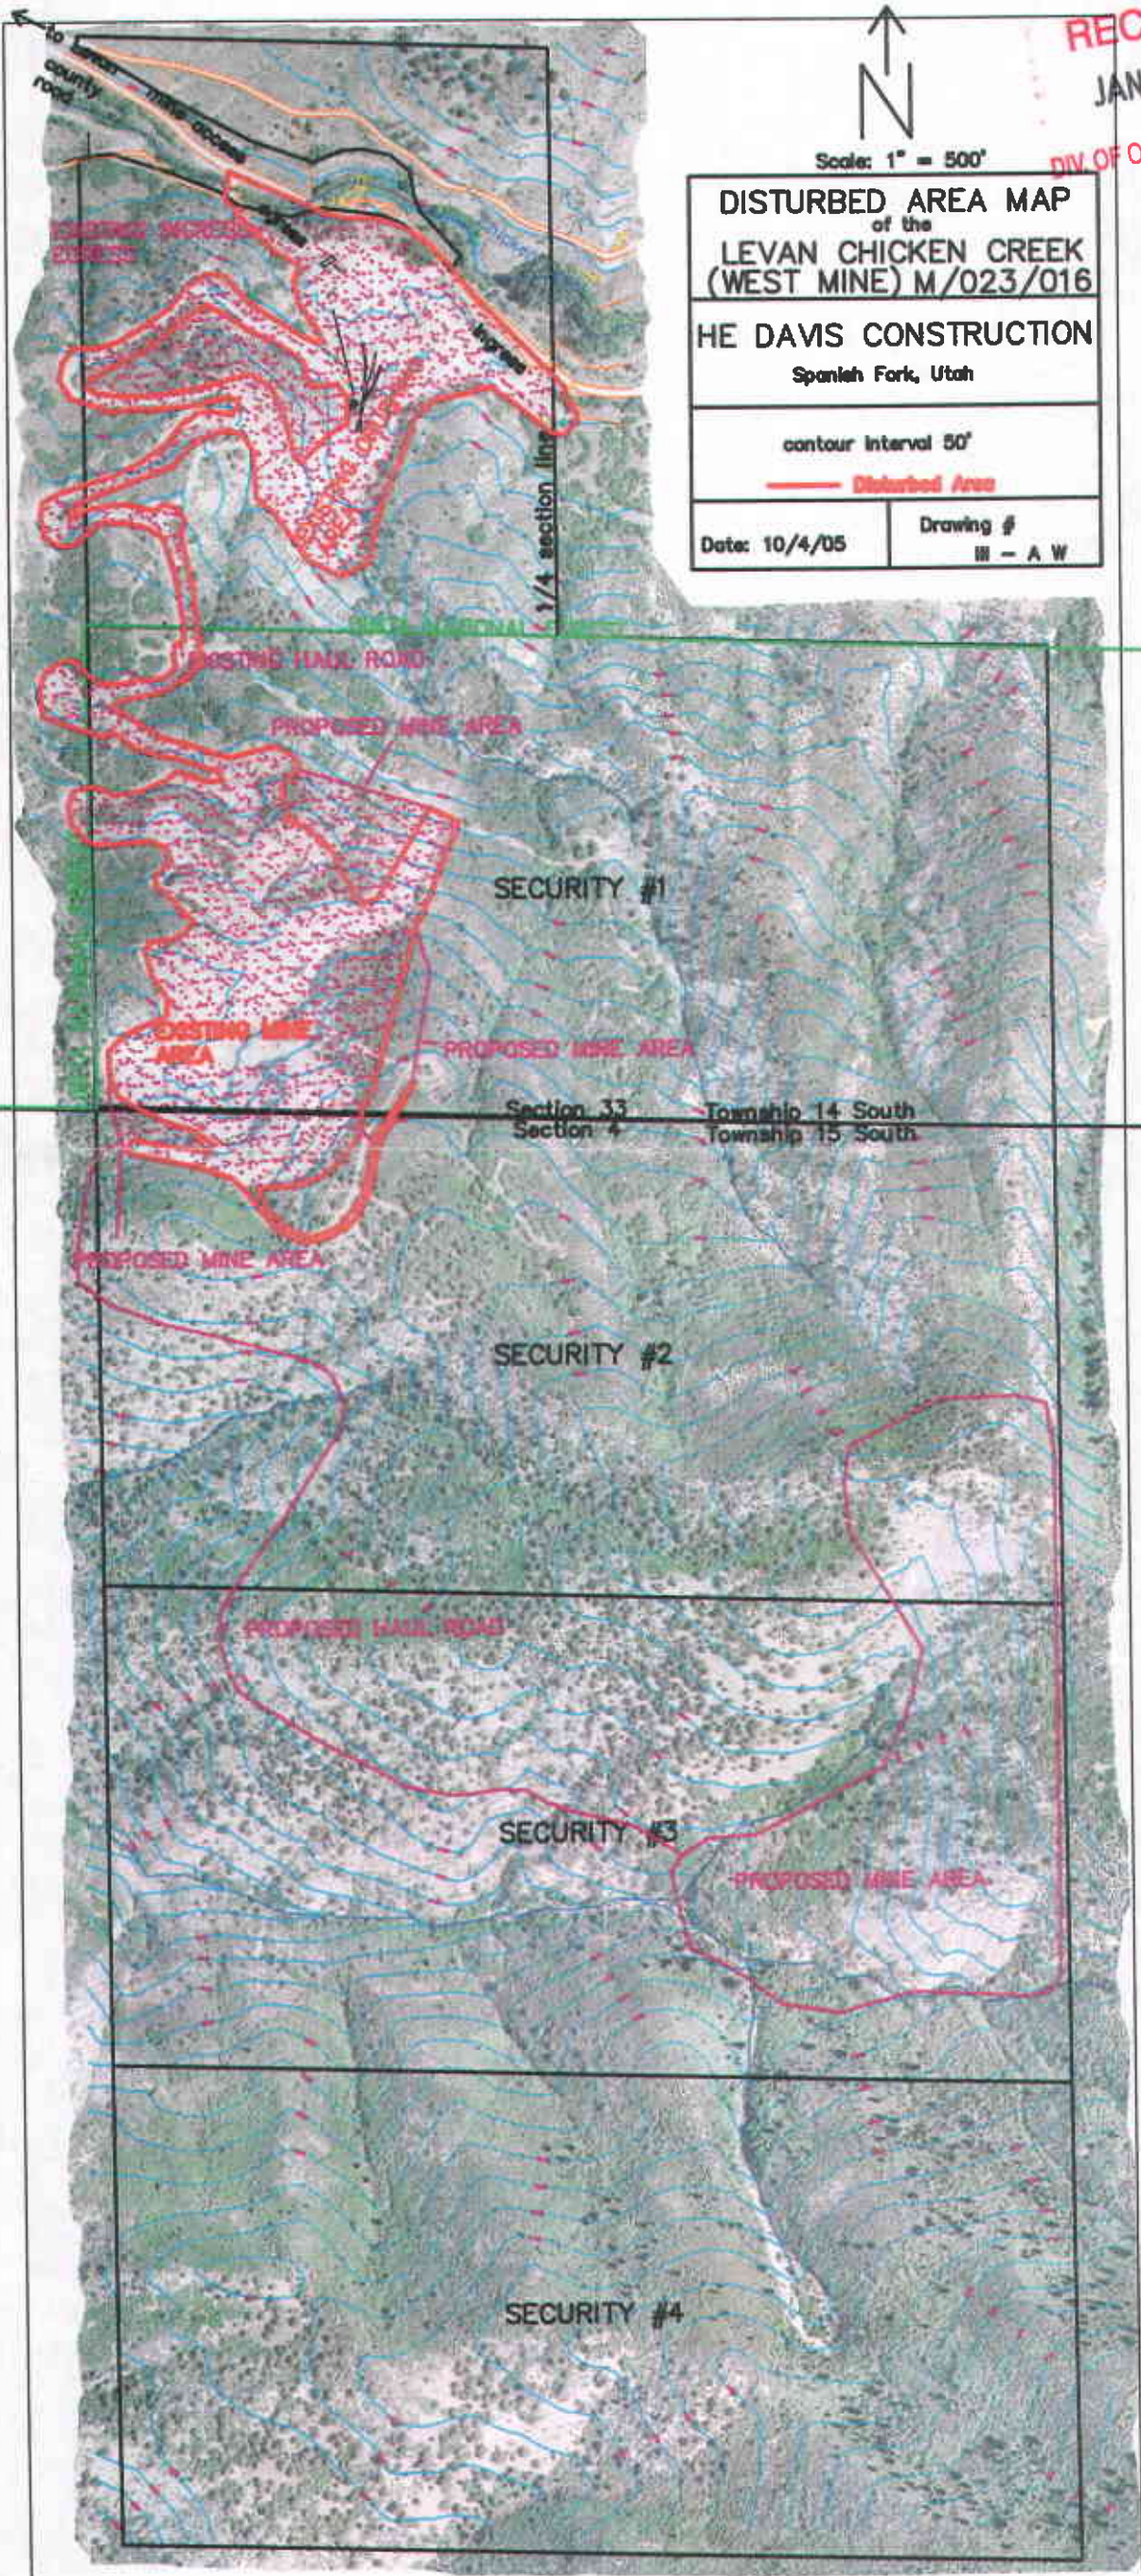



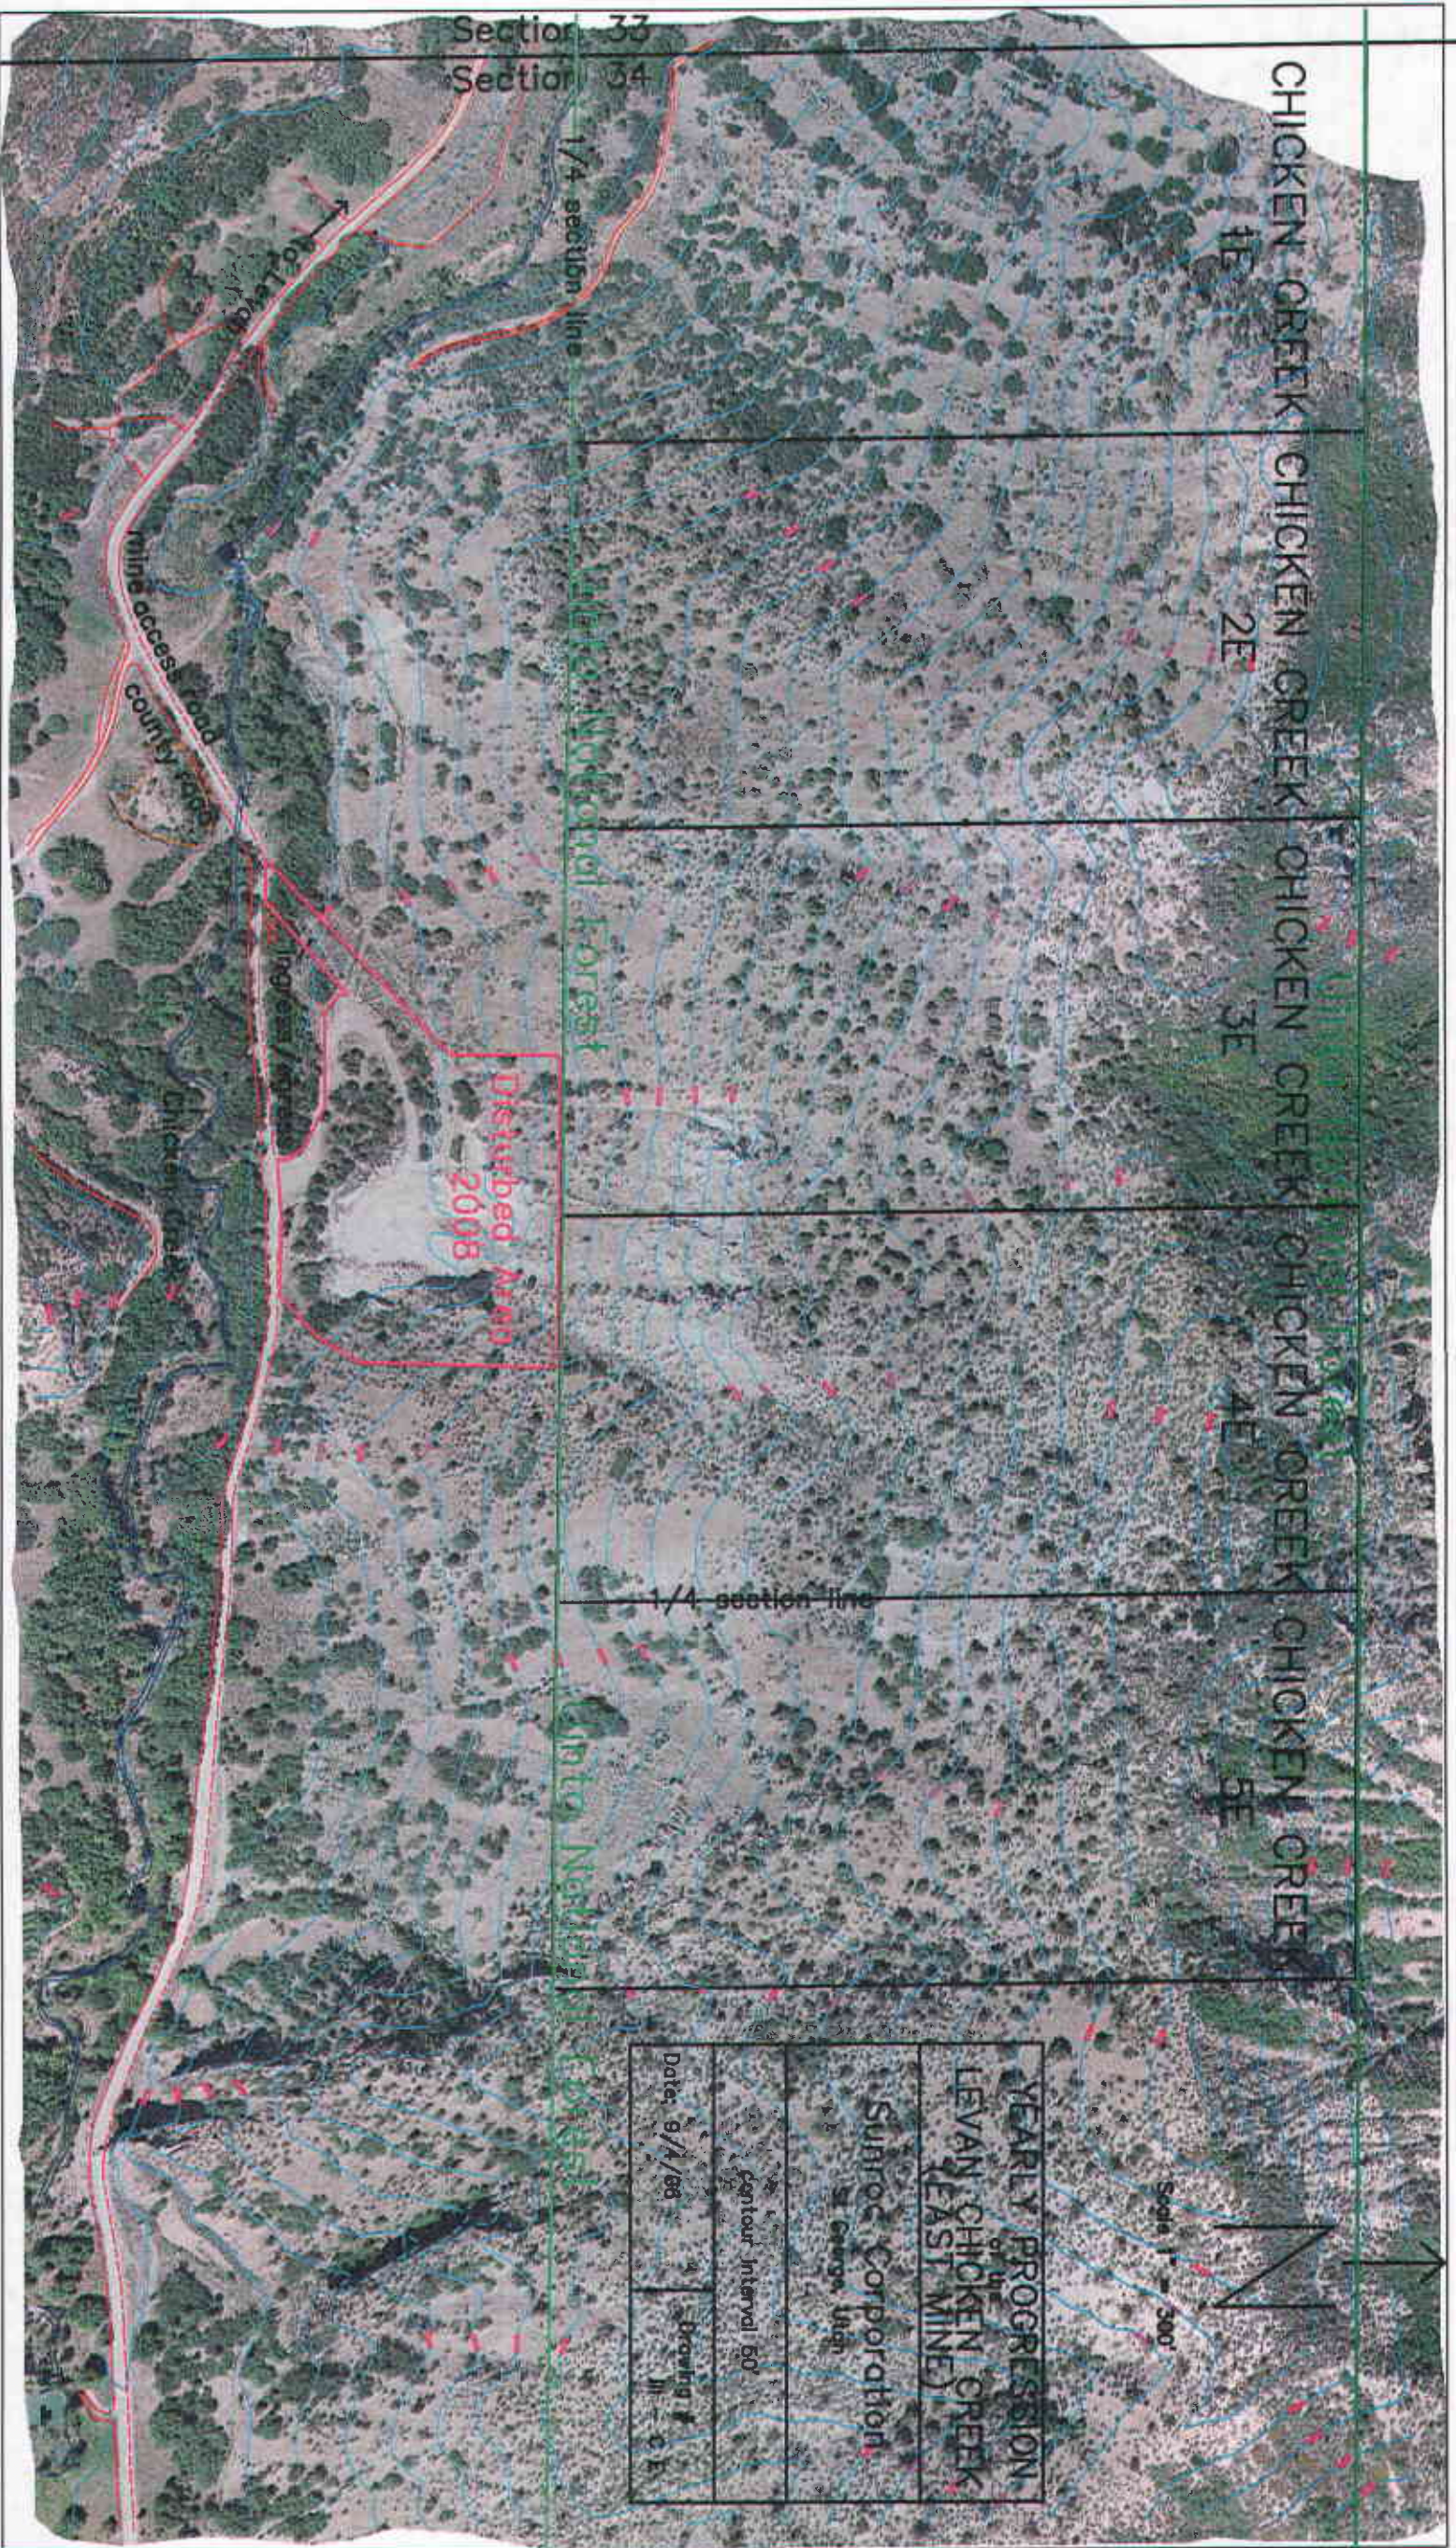

CHICKEN CREEK CHICKEN CREEK CHICKEN CREEK CHICKEN CREEK CHICKEN CREEK

4E

2E

3E

4E

5E

Utah National Forest

Utah National Forest

Section 33  
Section 34

1/4 section line

1/4 section line

Disturbed Area  
2008

mine access road

Scale 1" = 300'



|                                  |                      |
|----------------------------------|----------------------|
| YEARLY PROGRESSION               |                      |
| LEVAN CHICKEN CREEK<br>EAST MINE |                      |
| Sunroc Corporation               |                      |
| St George, Utah                  |                      |
| Contour Interval 60'             |                      |
| Date 9/1/08                      | Drawing # III - C.D. |